

**SCDHEC OFFICE OF OCEAN AND COASTAL RESOURCE MANAGEMENT  
PERMIT APPLICATION PUBLIC NOTICE**

**March 23, 2007**

**Permit Number:** OCRM-07-828  
**Permit ID:** 58052

The SCDHEC Office of Ocean and Coastal Resource Management has received an application for a permit for the alteration of a critical area. This application was submitted pursuant to the Coastal Zone Management Act (Act 123) of the 1977 South Carolina General Assembly. The application, in brief, is described as follows:

**APPLICANT:** Allen E Smith  
C/o O'Quinn Marine Construction Inc  
95 Sheppard Rd  
Lady's Island SC 29907

**LOCATION:** On and adjacent to Battery Creek at 27 Anchorage Way, Beaufort, Beaufort County, South Carolina.  
TMS#: R120-032-000-0191-0000.

**WORK:** The work proposed consists of making additions to an existing private dock. Proposed is the addition of a 12'x13' 4 pile boatlift on the shoreward side of the existing 12'x30' floating dock. The purpose for the dock addition is for the owner's private recreational use.

This public notice is being distributed to all known interested persons and agencies to assist in developing facts on which a decision by OCRM can be based. Comments concerning the proposed work should be submitted in writing, setting forth sufficient detail to furnish a clear understanding of the reasons for support or opposition.


The decision to issue or deny a permit will be based on the individual merits of the application, the policies specified in the South Carolina Coastal Zone Management Act, and the considerations outlined in the State of South Carolina Coastal Zone Management Program. Interested parties who wish to be notified of final permit action must notify OCRM in writing of this request.


*To assure review by OCRM, comments regarding this application must be received by OCRM on or before April 7, 2007.*

**PLEASE REPLY TO:**

SCDHEC OFFICE OF OCEAN AND COASTAL RESOURCE MANAGEMENT  
104 Parker Drive  
Beaufort, South Carolina 29906

**Please refer to P/N# OCRM-07-828**

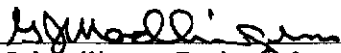  
\_\_\_\_\_  
G. J. Madlinger, Project Manager

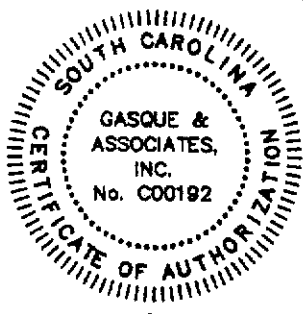


**GASQUE & ASSOCIATES INC.**  
**LAND SURVEYORS & PLANNERS**

28 PROFESSIONAL VILLAGE CIRCLE, BEAUFORT, S.C.  
P.O. BOX 1363, BEAUFORT, S.C.  
PHONE (843) 522-1798

NOTE;  
DISTANCES AND PLACEMENT OF DOCKS  
MUST BE VERIFIED BY CONTRACTOR

DRAWING NOT TO SCALE

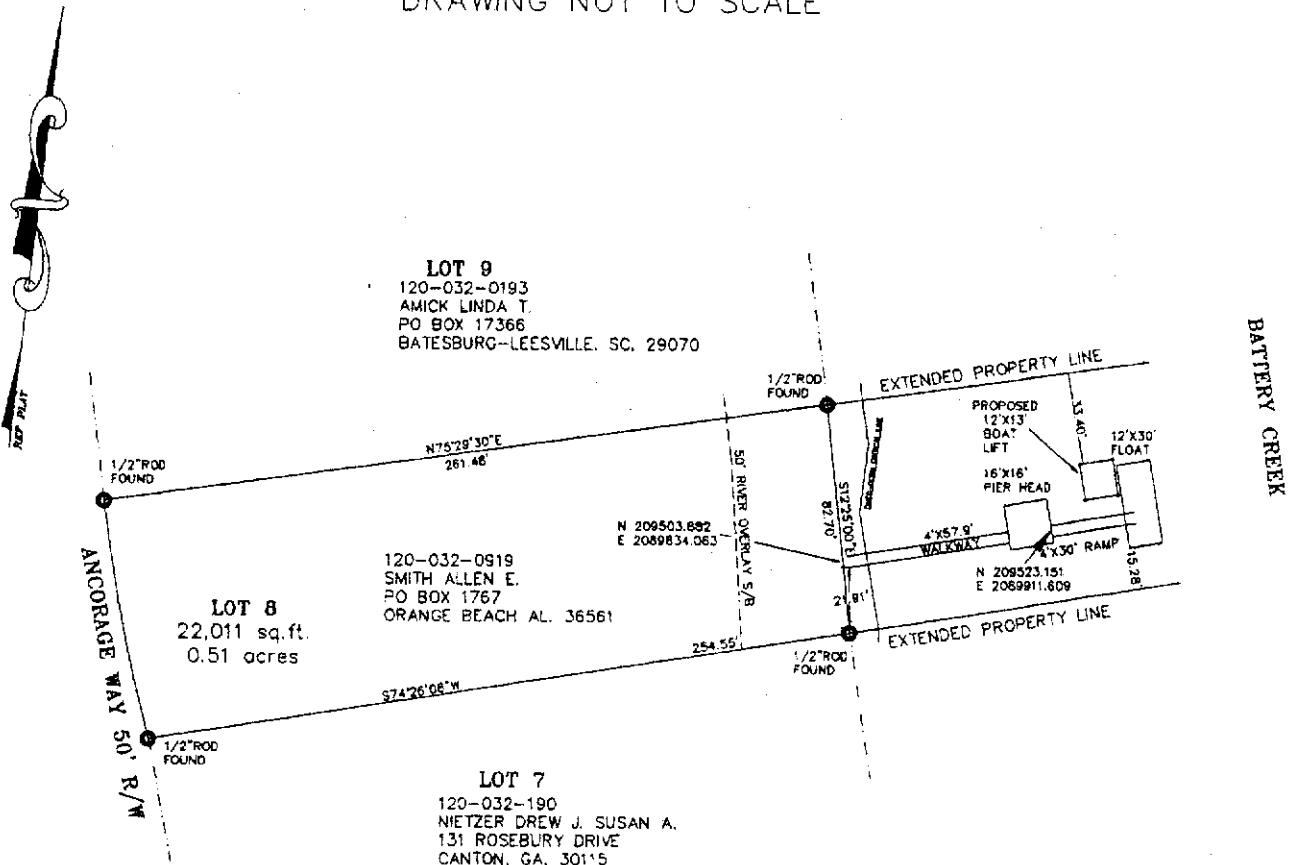

CURVE TABLE						
CURVE	LENGTH	RADIUS	TANGENT	CHORD	BEARING	DELTA
C1	87.49	675.00	43.80	87.42	S17°05'56\"E	07°25'34\"

DOCK ASBUILT SURVEY PREPARED FOR ALLEN SMITH  
I HEREBY CERTIFY TO THE LOCATION OF DOCK ONLY

OCR M-01-828

DATE: 2/15/07

DAVID E. GASQUE, R.L.S.

JOB # 33031  
FB/DA/A.E. DSGN#3

APPLICANT: 120-032-0919  
SMITH ALLEN E.  
PO BOX 1767  
ORANGE BEACH AL. 36561

ACTIVITY: PRIVATE RECREATIONAL DOCK


LOCATION: 27 ANCHORAGE WAY

COUNTY: BEAUFORT, SC.  
DATE: 2/15/07

ADJACENT PROPERTY OWNERS:

LOT 7  
120-032-190  
NIETZER DREW J. SUSAN A.  
131 ROSEBURY DRIVE  
CANTON, GA. 30115

LOT 9  
120-032-0193  
AMICK LINDA T.  
PO BOX 17366  
BATESBURG-LEESVILLE, SC. 29070

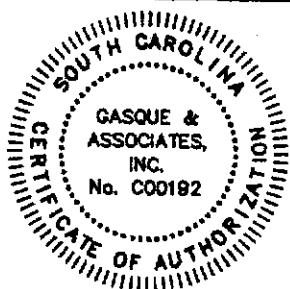


GASQUE & ASSOCIATES INC.  
LAND SURVEYORS & PLANNERS

28 PROFESSIONAL VILLAGE CIRCLE, BEAUFORT, S.C.  
P.O. BOX 1363, BEAUFORT, S.C.  
PHONE (843) 522-1798

NOTE;  
DISTANCES AND PLACEMENT OF DOCKS  
MUST BE VERIFIED BY CONTRACTOR

DRAWING NOT TO SCALE

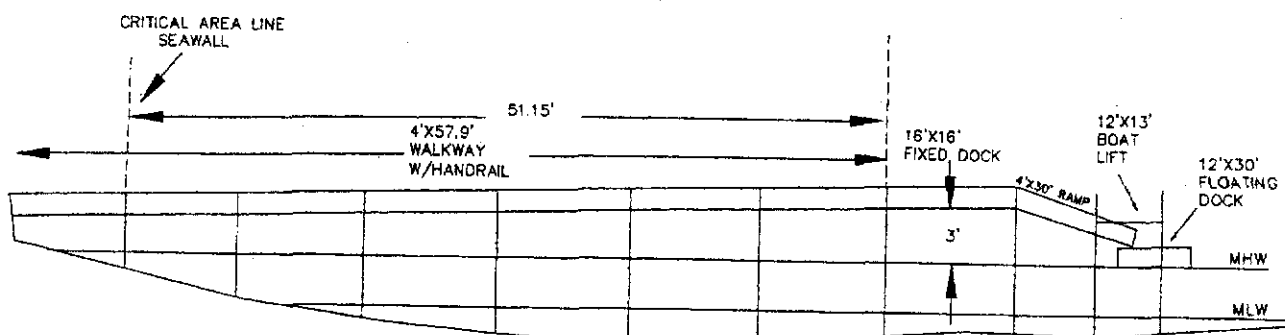

DRAWING NOT TO SCALE

DOCK ASBUILT SURVEY PREPARED FOR ALLEN SMITH  
I HEREBY CERTIFY TO THE LOCATION OF DOCK ONLY

OCRM-07-828

DATE: 2/15/07

DAVID E. GASQUE, R.L.S.

3-1-07

JOB # 33031  
FB#NA/A.E. DSGN#3

APPLICANT: 120-032-0919  
SMITH ALLEN E.  
PO BOX 1767  
ORANGE BEACH AL. 36561

ACTIVITY: PRIVATE RECREATIONAL DOCK

LOCATION: 27 ANCHORAGE WAY


COUNTY: BEAUFORT, SC.  
DATE: 2/15/07

ADJACENT PROPERTY OWNERS:

LOT 7  
120-032-190  
1. NIETZER DREW J. SUSAN A  
131 ROSEBURY DRIVE  
CANTON, GA. 30115

LOT 8  
120-032-0193  
2. AMICK LINDA T.  
PO BOX 17366  
BATESBURG-LEESVILLE, SC. 29070

Central  
BEAUFORT COUNTY, SC  
MAP #1

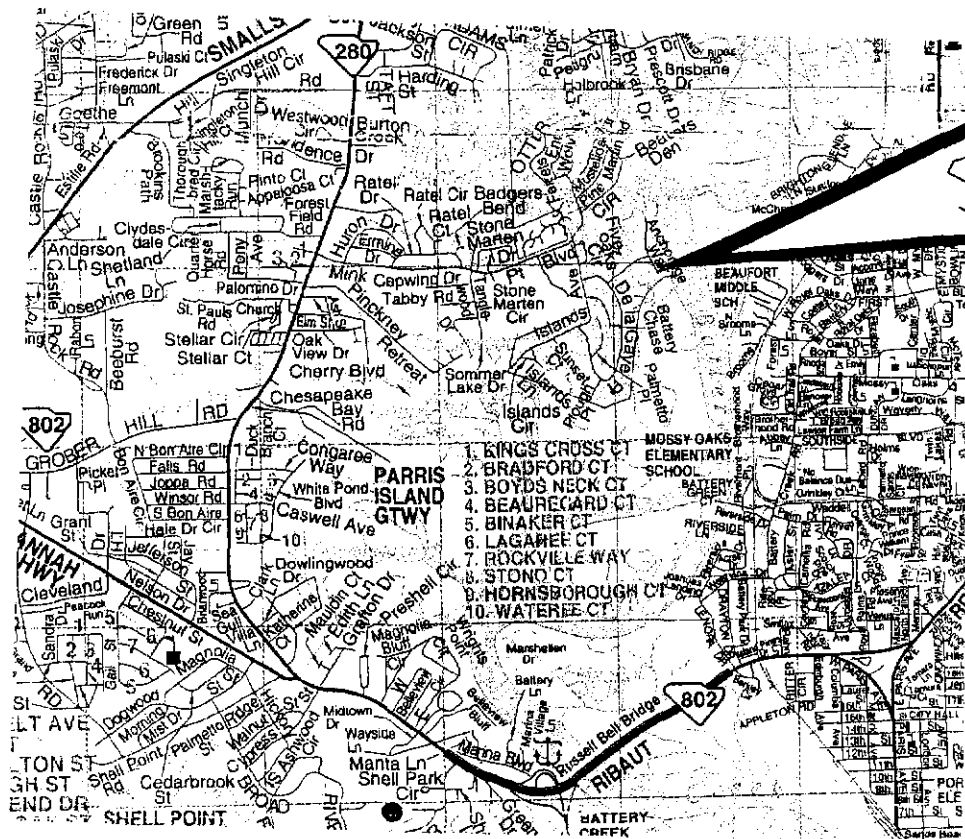

Take US 215, turn right into SR 280 - (Parris Island Gateway). At Mink Point traffic signal turn left onto Mink Point Blvd, turn right onto Islands Ave, turn left onto De la Gaze Pt and then turn left into Anchorage Way.

APPLICANT: Allen Smuts

ACTIVITY: Boat Lift  
Addition

P/N # OCRM-07-828

LOCATION: 27 Anchorage Way

COUNTY: Beaufort

DATE: 3/20/07

ADJACENT PROPERTY OWNERS:

1. Drew Nietzer
2. Linda Annick